


Scale: 1" = 30'

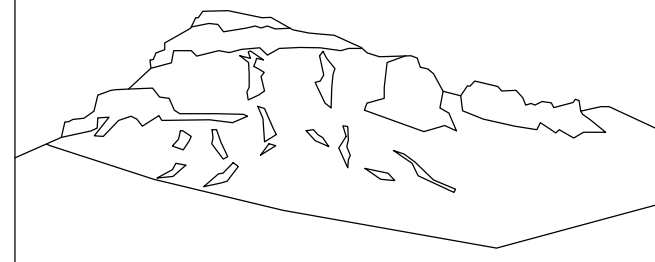


**Uncompahgre  
Engineering, LLC**

P.O. Box 3945  
Telluride, CO 81435  
970-729-0683

**SUBMISSIONS:**

WINDHORSE PRELIMINARY PUD/SUBDIVISION	2017-09-15
PRELIMINARY PLAT SUBMITTAL FOR PLANNING COMMISSION HEARING ON DEC. 14, 2017	2017-11-14
FINAL PLAT SUBMITTAL	2018-05-04
PUBLIC WORKS CHANGES	2018-06-28
NOTE AND LABEL CHANGE	2018-08-22

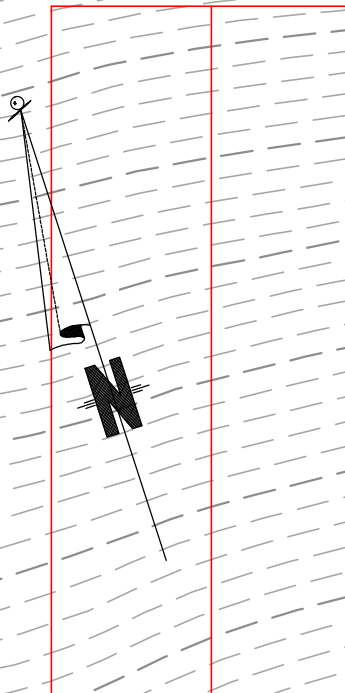

NOTE: TOT LOT LINES HAVE NOT BEEN RECORDED. THESE LOT LINES ARE ASSUMED IN ORDER TO INSTALL THE SERVICES.

**The Overlook  
at Telluride**

**Subdivision/PUD  
Primrose Lane  
Telluride, CO**



CONTRACTOR TO REVIEW AND COMPARE ALL CHAPTERS AND INTERDISCIPLINARY DRAWINGS AND REPORT ANY DISCREPANCIES TO THE ARCHITECT PRIOR TO ANY FIELD WORK BEING DONE IN ACCORDANCE WITH AIA DOCUMENT A201

**Franklin  
Plan Showing  
Section Lines**

Scale: 1" = 30'

